

In the Drawings:

Please amend Figures 1, 3, and 8 as shown in red in the attached Figures. Upon acceptance by the Examiner, formal drawings will be submitted.

PATENT

IN THE UNITED STATES PATENT AND TRADEMARK OFFICE

Applicants : Dennis Roy Mullins et al.
Application No. : 09/914,853
Filed : November 26, 2001
For : NEIGHBOURING CELL LIST GENERATION IN A MOBILE
SATELLITE COMMUNICATION SYSTEM

Examiner : Rafael Perez Gutierrez
Art Unit : 2686
Docket No. : 57724-52
Date : August 26, 2004

Mail Stop Amendment
Commissioner for Patents
P.O. Box 1450
Alexandria, VA 22313-1450

RECEIVED

SEP 01 2004


REQUEST FOR DRAWING CHANGE

Technology Center 2600

Commissioner for Patents:

Drawing changes, as indicated in red on the attached drawings, are hereby submitted for approval by the Examiner.

Respectfully submitted,
Dennis Roy Mullins et al.
Davis Wright Tremaine LLP

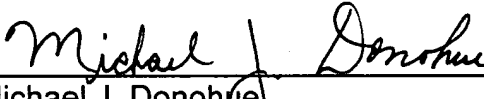

Michael J. Donohue
Registration No. 35,859

MJD:gatc

Enclosures:

Redlined Figures

2600 Century Square
1501 Fourth Avenue
Seattle, Washington 98101-1688
Phone: (206) 622-3150
Fax: (206) 628-7699

1288722_1.DOC

1 / 5

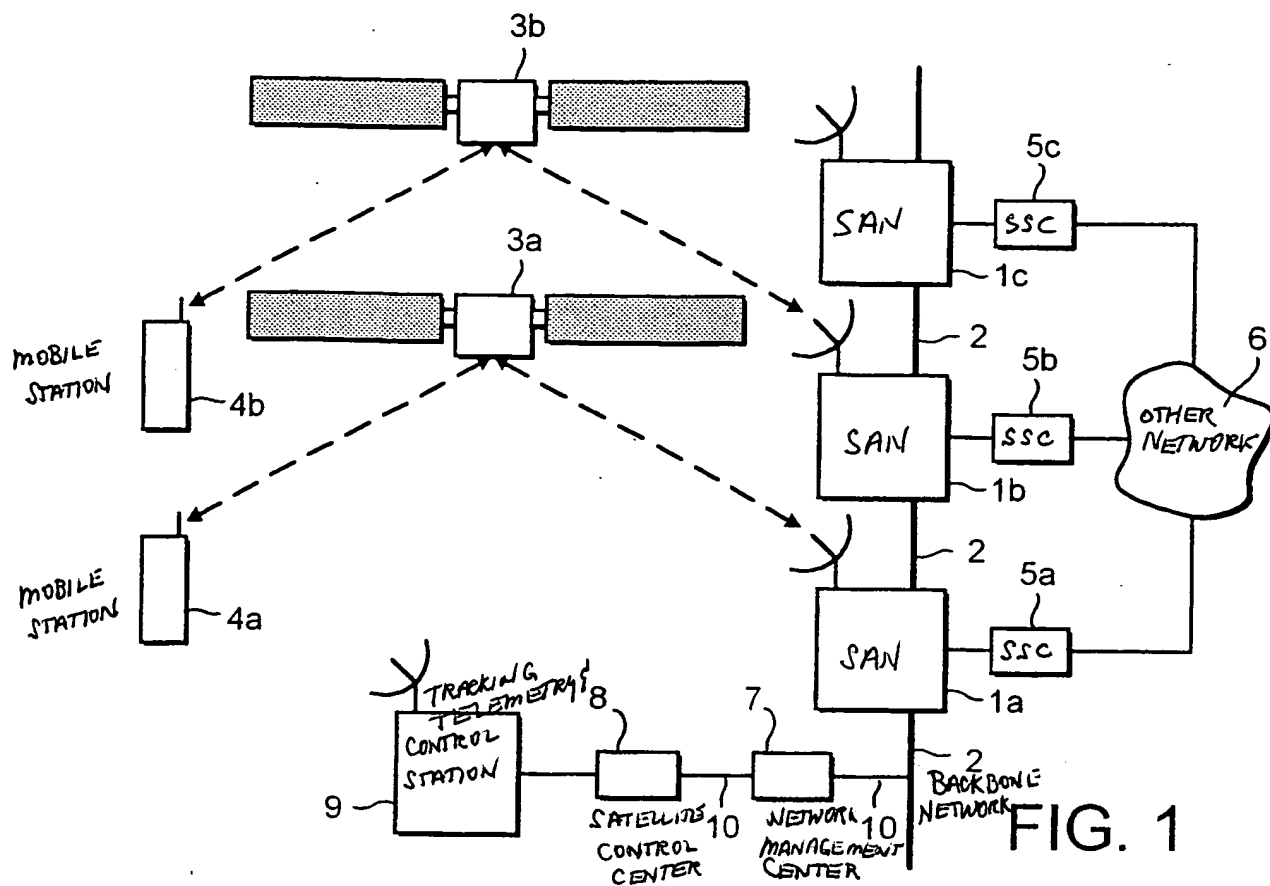


FIG. 1

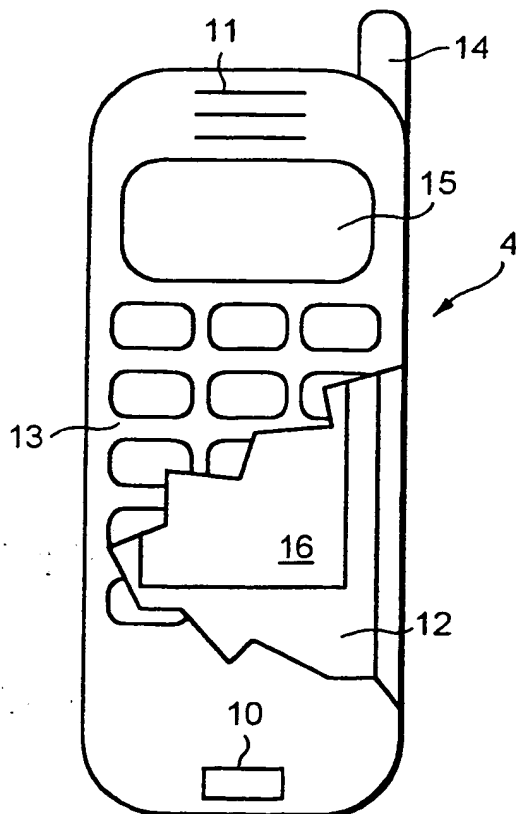


FIG. 2

2 / 5

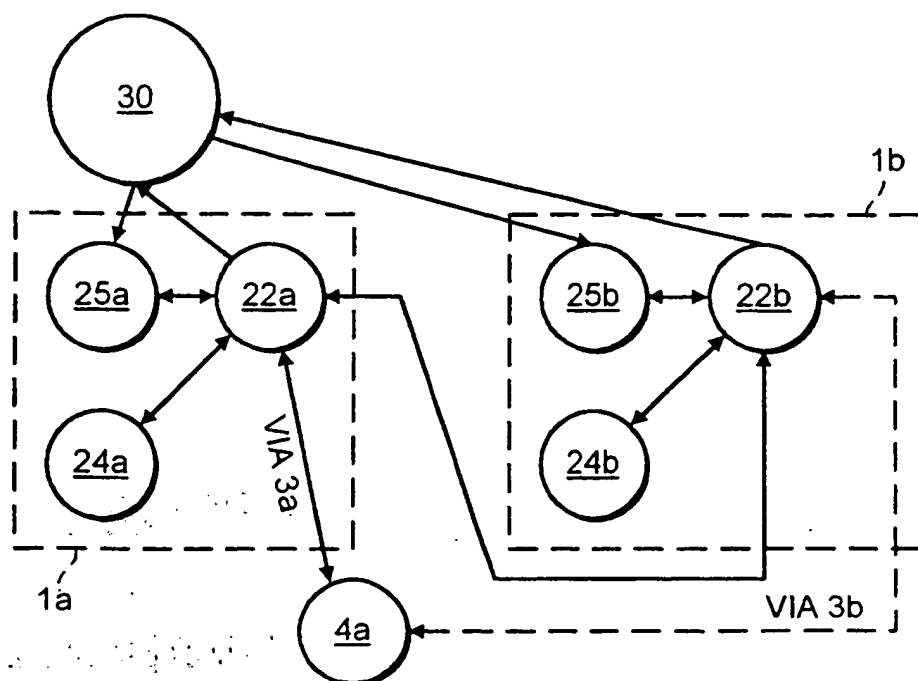
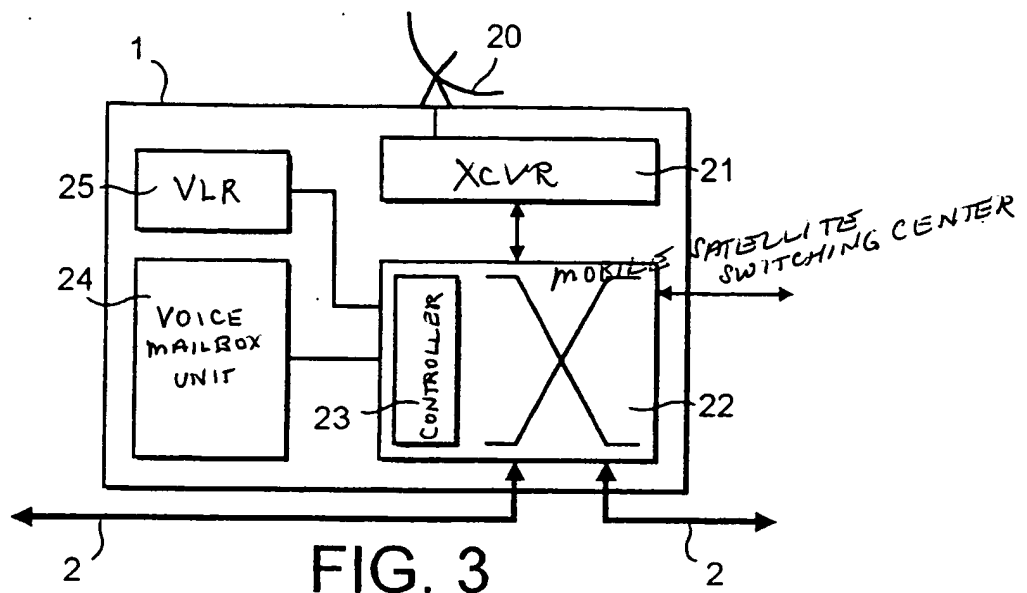


FIG. 4

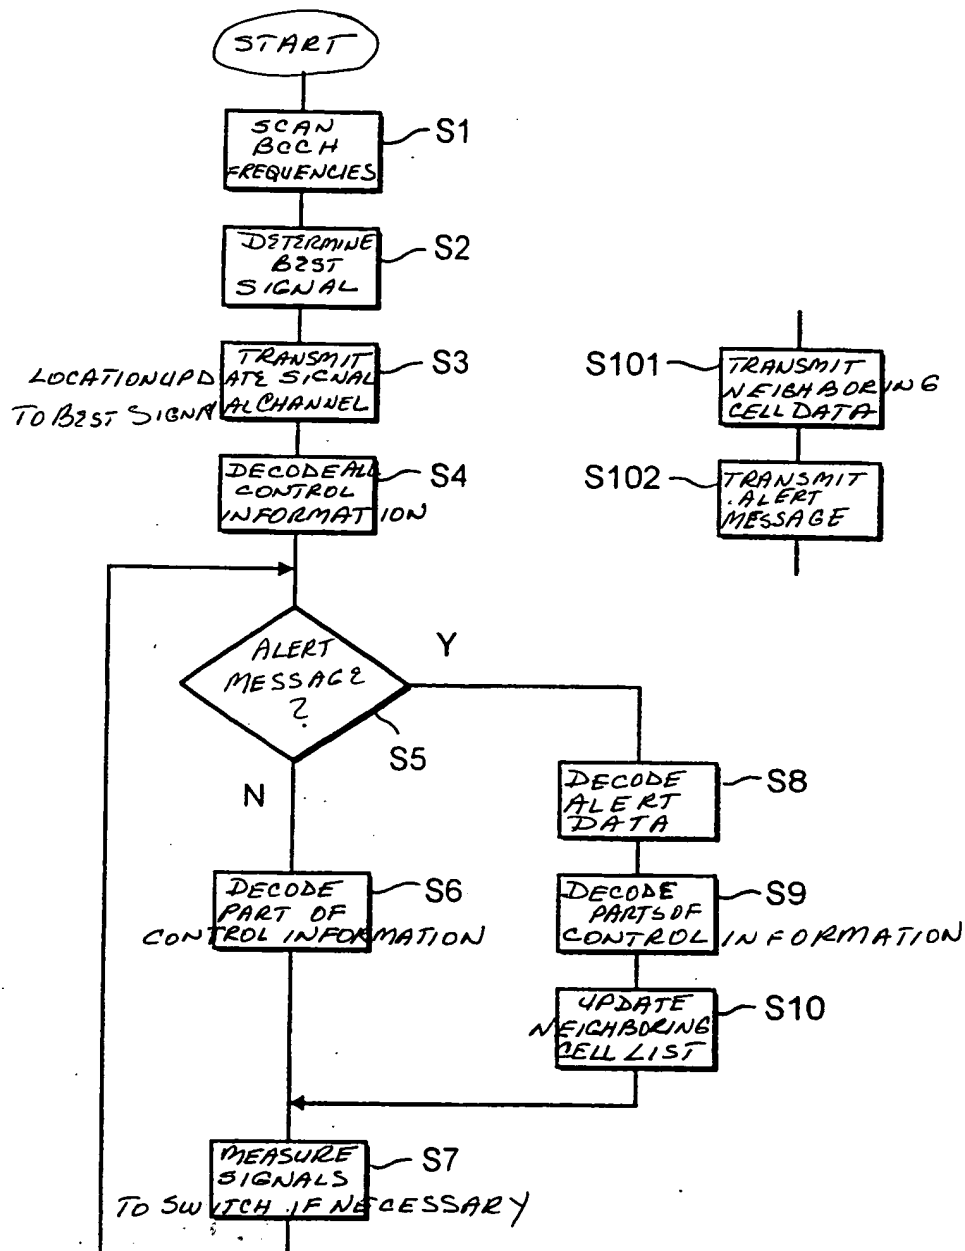


FIG. 8